




REFLECTED CEILING PLAN (1) GRG DOME
1/2" = 1'-0"

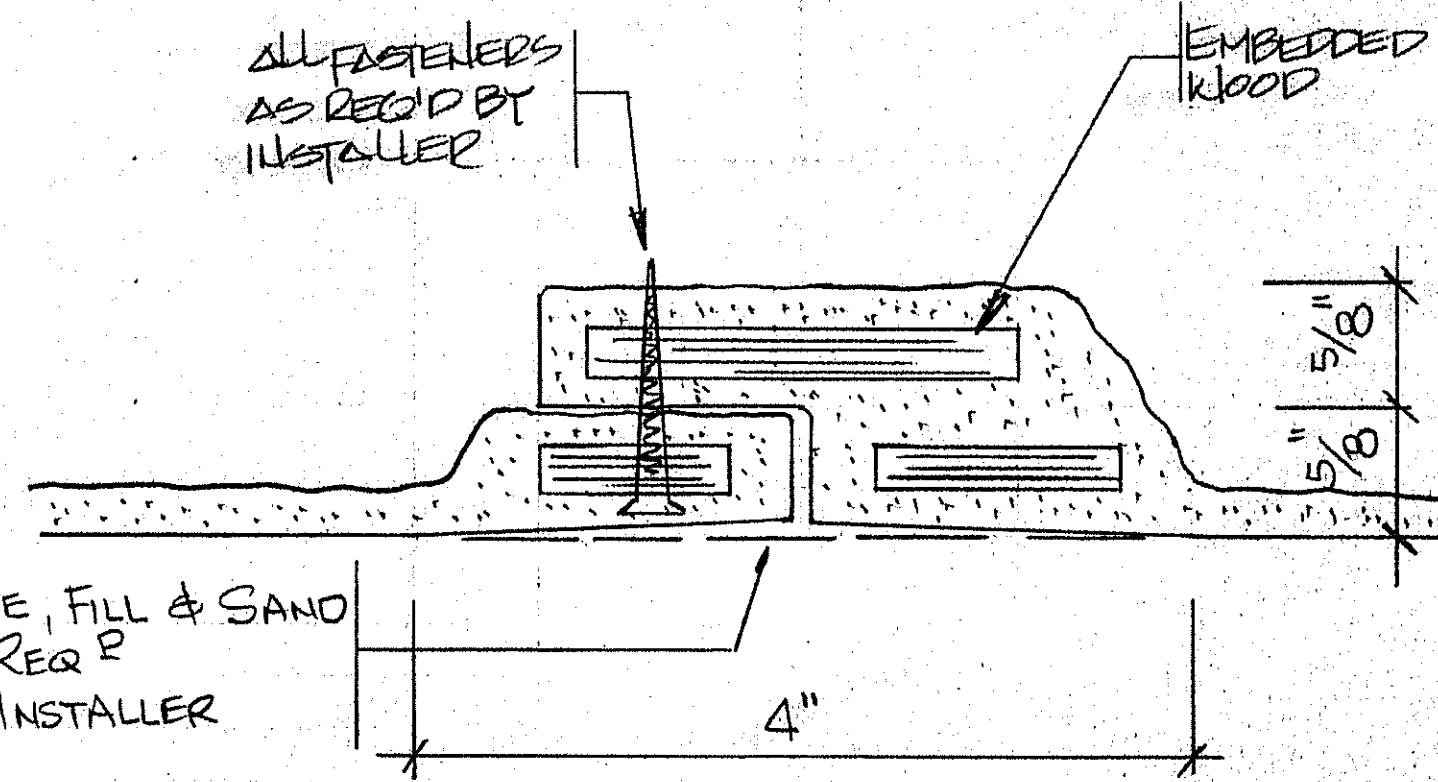


DETAIL (3) JOINT
FULL (D1)

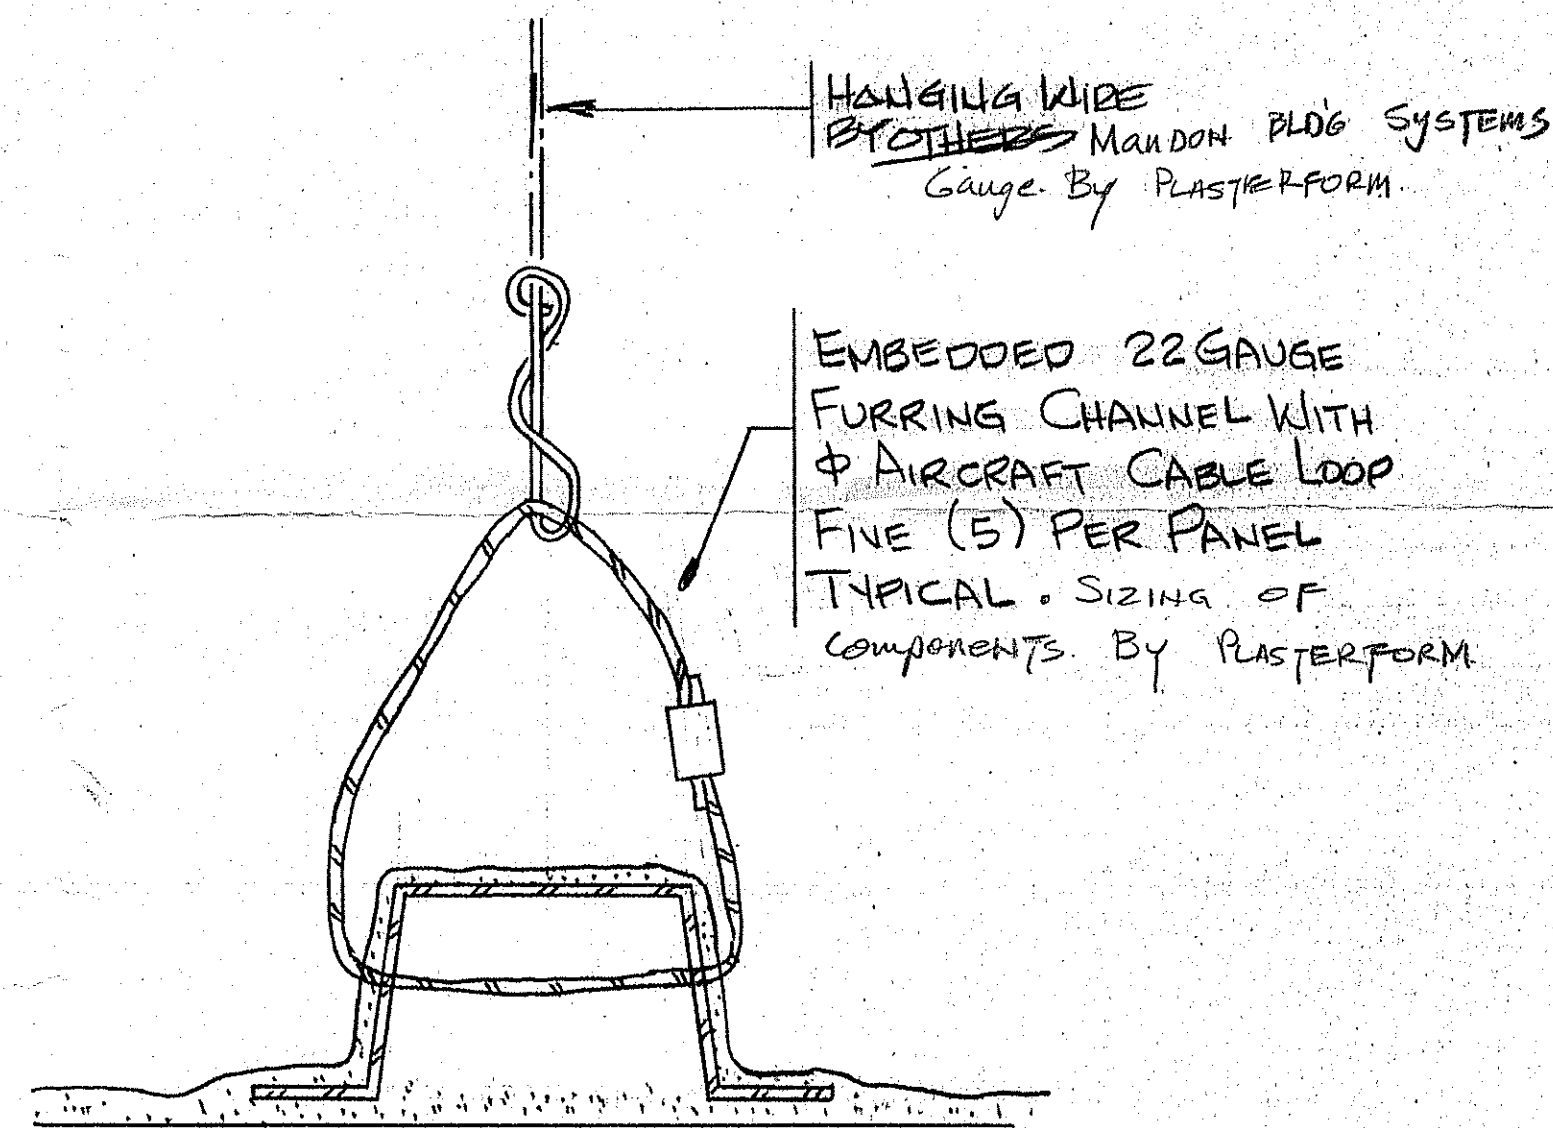

DETAIL (4) SUSPENSION
FULL (D1)

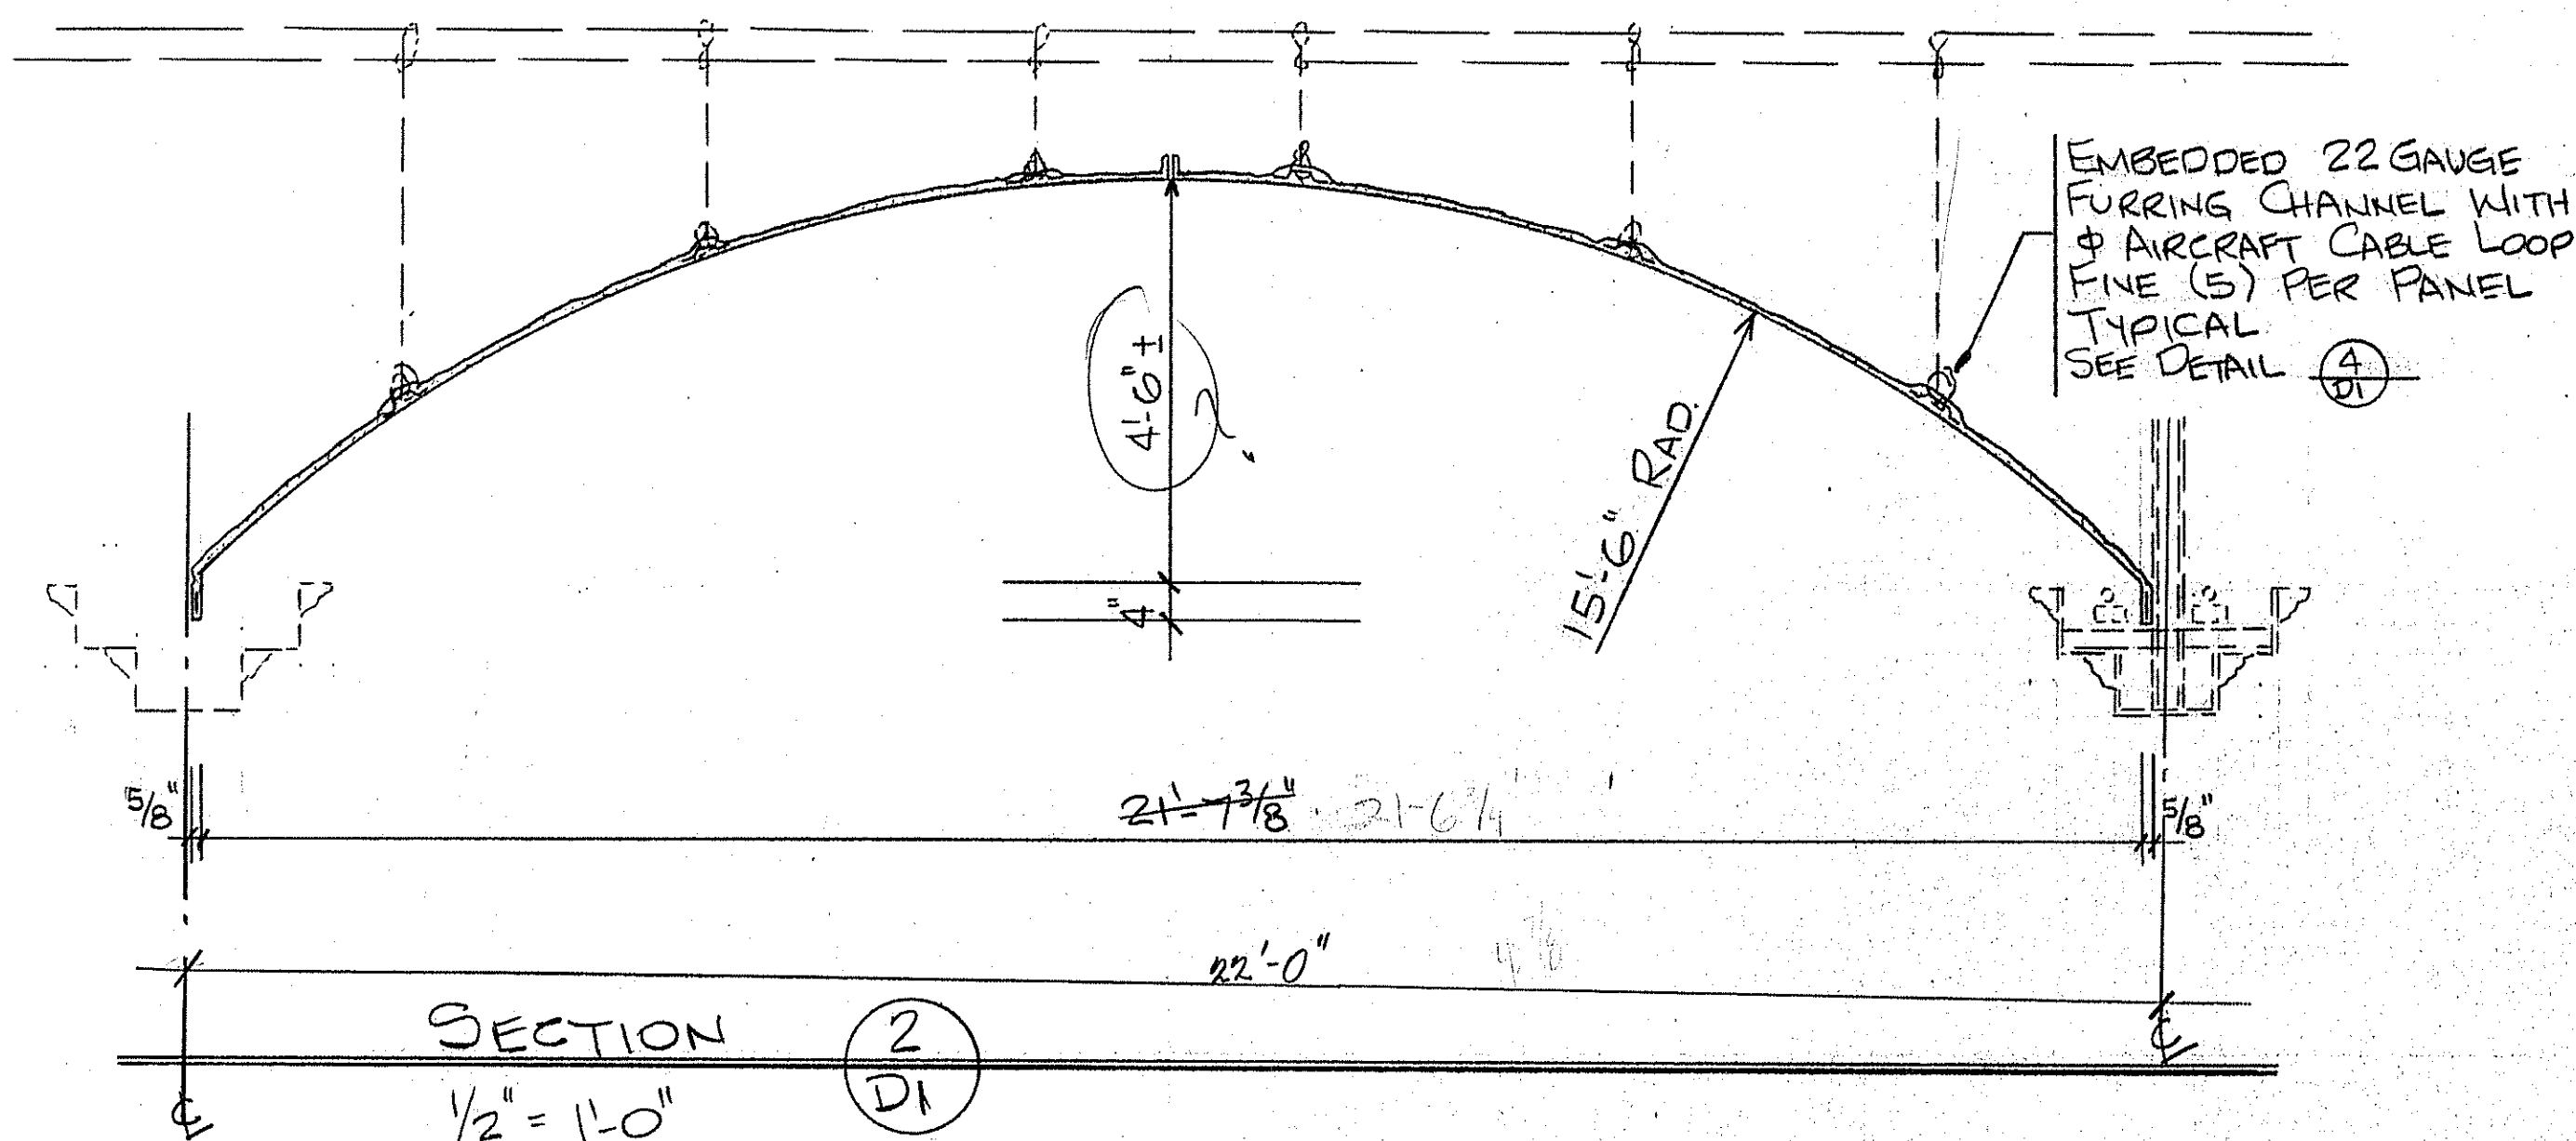

SECTION (2)
1/2" = 1'-0"

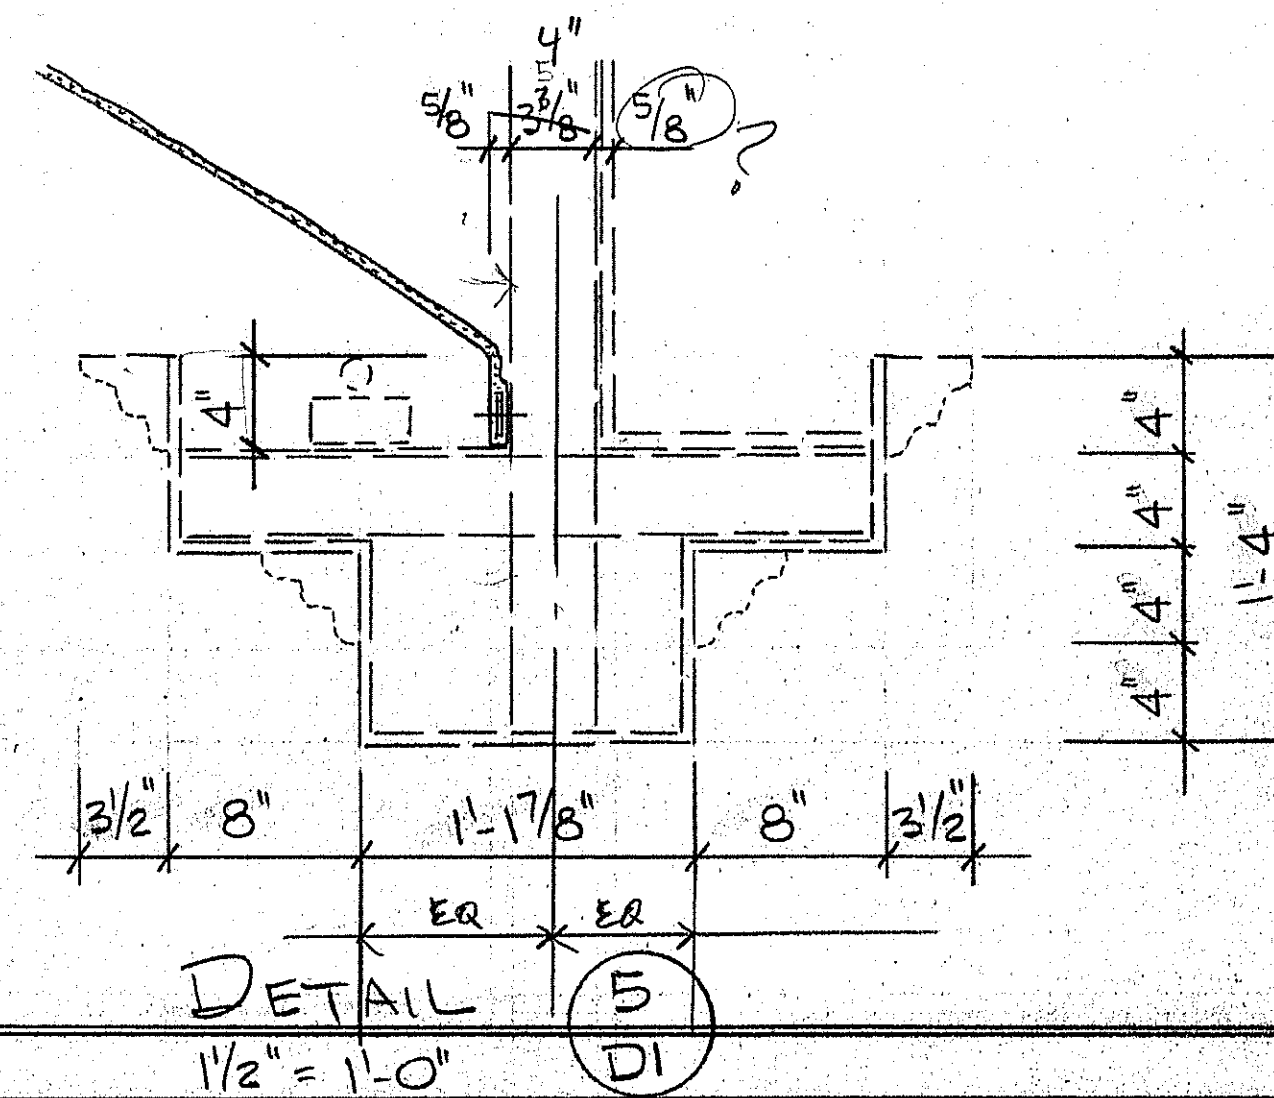

DETAIL (5)
1/2" = 1'-0"

NO EXCEPTION TAKEN REVISE AND RESUBMIT.
 REJECTED FURNISH AS CORRECTED.
 Corrections or comments made on the shop drawings during this review do not relieve contractor from compliance with requirements of the drawings and specifications. This check is only for review of general performance with the design concept of the project and general compliance with the information given in the contract documents. The contractor is responsible for: confirming and correlating all quantities and dimensions; selecting fabrication processes and techniques of construction; coordinating his work with that of all other trades; and performing his work in a safe and satisfactory manner.
MUSSACHIO ARCHITECTS P.C.
 Date 2/19/94 By ACM

- GENERAL NOTES
1. HANDLE ALL COMPONENTS WITH CARE.
 2. STORE COMPONENTS LEVEL IN A DRY CLEAN AREA.
 3. PROTECT COMPONENTS FROM WEATHER AND DAMAGE.
 4. DO NOT STACK COMPONENTS ON EACH OTHER.
 5. DO NOT LEAN - STAND UPRIGHT WITH EACH COMPONENT BEARING OWN WEIGHT.
 6. ALL FRAMING, HARDWARE, CLIPS, ETC. BY OTHERS.
 7. SHIM AS REQUIRED BY INSTALLER.
 8. USE ONLY GALVANIZED SCREWS FOR EXTERIOR INSTALLATIONS.
 9. FIELD TAPE, PATCH, CAULK OR GROUT AS REQUIRED.
 10. FIELD FINISHING AS REQUIRED BY OTHERS.
 11. CONTACT PLASTERFORM FOR ASSISTANCE.

BILL OF MATERIAL

TYPE	QTY	REMARKS
A	1	2 5
A1	10	2 5
A2	1	2 5

TOTAL 12 PIECES

NO.	DESCRIPTION	DATE	BY
2			
1			

PlasterFORM
DECORATIVE ARCHITECTURAL SYSTEMS

6895 Menway Court, Mississauga, Ontario
Canada, L5S 1W2. Tel. (416) 877-8390
Fax (416) 877-9601 1-800-268-4534

Ellicott Square Building, Suite 947
Buffalo, New York, 14203

1-800-268-4534

PROJECT:
ISLAMIC CENTRE
AMHERST N.Y.

DRAWING:
GRG DOME

DRAWN BY: JW	CHECKED BY:
DATE: 02/02/94	SCALE: NOTED
PROJECT NO: 94-106	DRAWING NO: D1
	1 of 1

02/02/94
 Islamic Center - G-3 Dome
 15/5/94
 02/02/94